
PROJECT NO. 2103 LOCATION: The S1/2 NE1/4 & N1/2 SE1/4, Section 31-95-34, Palo Alto Co., IA REQUESTOR: Midwest Land, P.O. Box 909, Spencer, IA 51301-0909 OWNER: Prior - Fouts, Etal. 4819 147th St., Urbandale, IA 50323 SURVEYOR: E. JOHN WITTNEBEN SURVEY: 01/27/2021 SURVEY COMPANY: WITTNEBEN SURVEYING, INC. DRAWN: 02/01/2021 303 W. 2nd St. N. SCALE: 1" = 500' ESTHERVILLE, IA 51334 712-362-4797 500 250 0 INDEX LEGEND 500 **GRAPHIC SCALE** 000 1500 2000

AT OF SURVEY

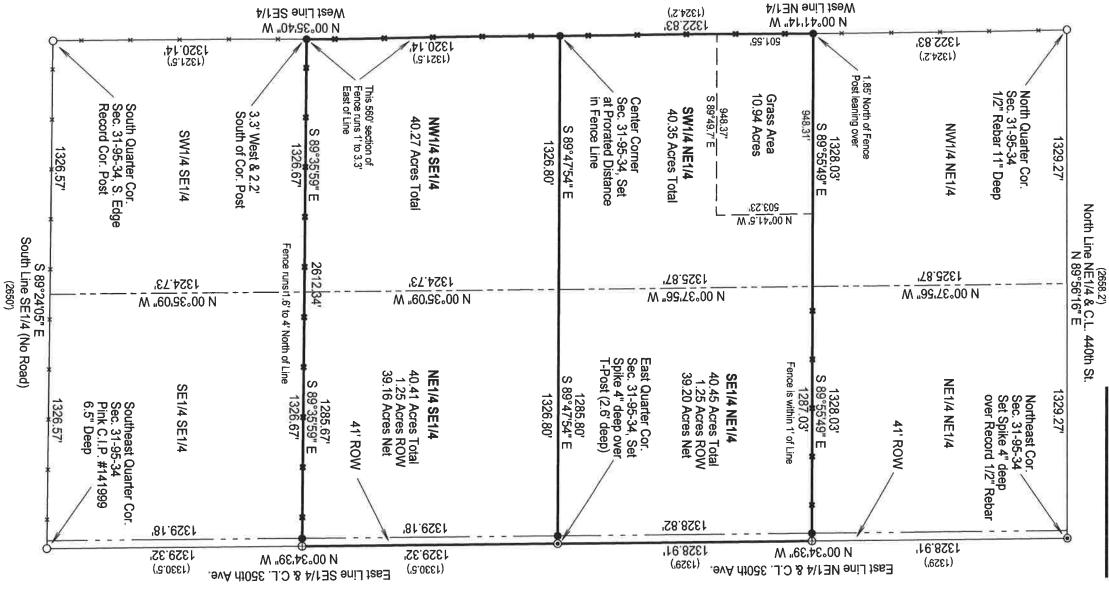

THE SOUTH HALF OF THE NORTHEAST QUARTER OF SECTION 31, TOWNSHIP 95 NORTH, RANGE 34 WEST OF THE 5th P.M., PALO ALTO COUNTY, IOWA, CONTAINING 80.80 ACRES INCLUSIVE OF 1.25 ACRES OF PUBLIC ROAD RIGHT-OF-WAY ALONG THE EASTERLY 41.00 FEET THEREOF.

THE NORTH HALF OF THE SOUTHEAST QUARTER OF SECTION 31, TOWNSHIP 95 NORTH, RANGE 34 WEST OF THE 5th P.M., PALO ALTO COUNTY, IOWA, CONTAINING 80.68 ACRES INCLUSIVE OF 1.25 ACRES OF PUBLIC ROAD RIGHT-OF-WAY ALONG THE EASTERLY 41.00 FEET THEREOF.

Surveyor's Note:
Record Dimensions refer to a Survey by
Record Surveyor Gary Campbell July 09, 1912,
as recorded in Survey Record Book 2, Page
77, County Engineer's Office.

LEGEND

* (1329) ***** 0 0 ⊕ Point Not Set

Set Spike Over Monument
Found Monument As Noted
Set 5/8"x30" Yellow C.I.P. #1

Record Dimension
Existing Fenceline
V Right-of-Way

. #14810

I hereby certify that this land surveying document was prepared and the related survey work was performed by me or under my direct personal supervision and that I am a duly Licensed Land Surveyor under the laws of the State of Iowa. E. John Wittneben, L.S. No. 14810
My License Renewal Date Is: 12/31/2022
Sheets Covered By This Seal: 1

